
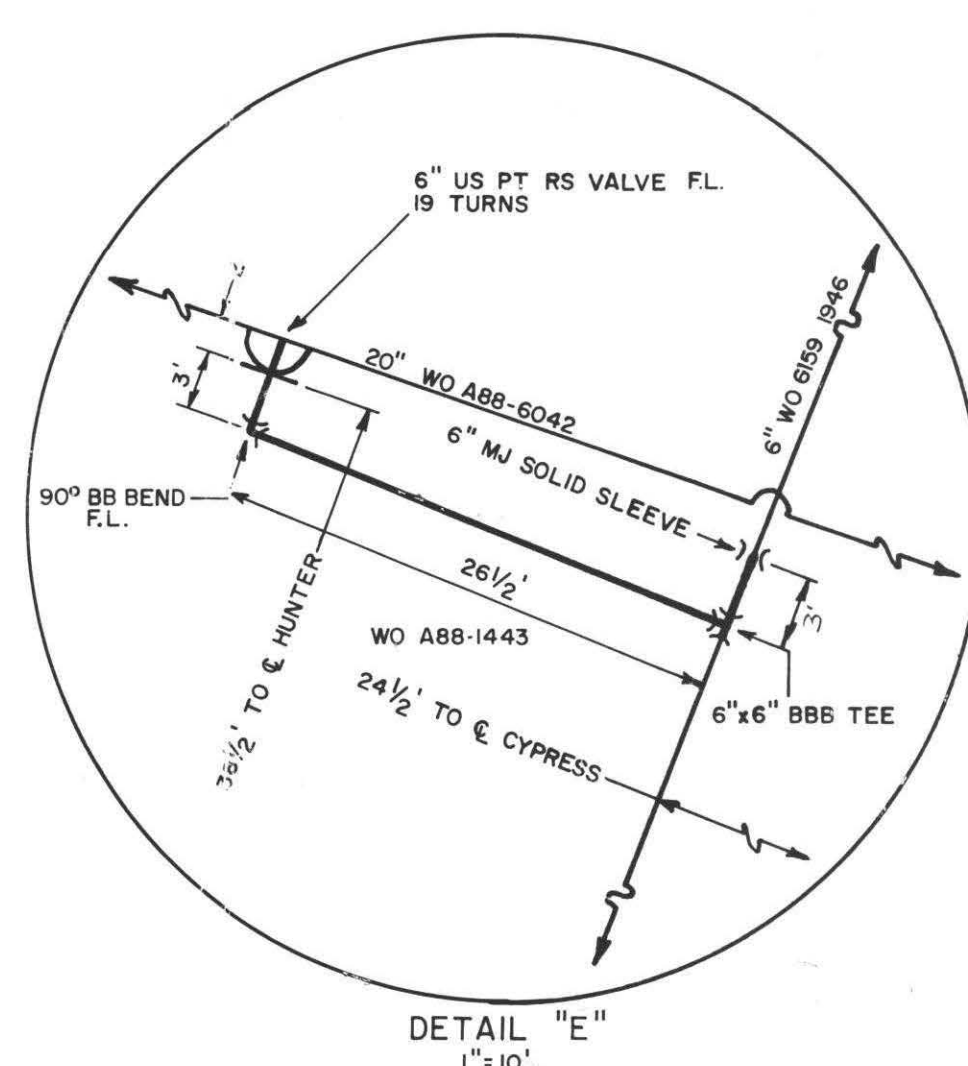
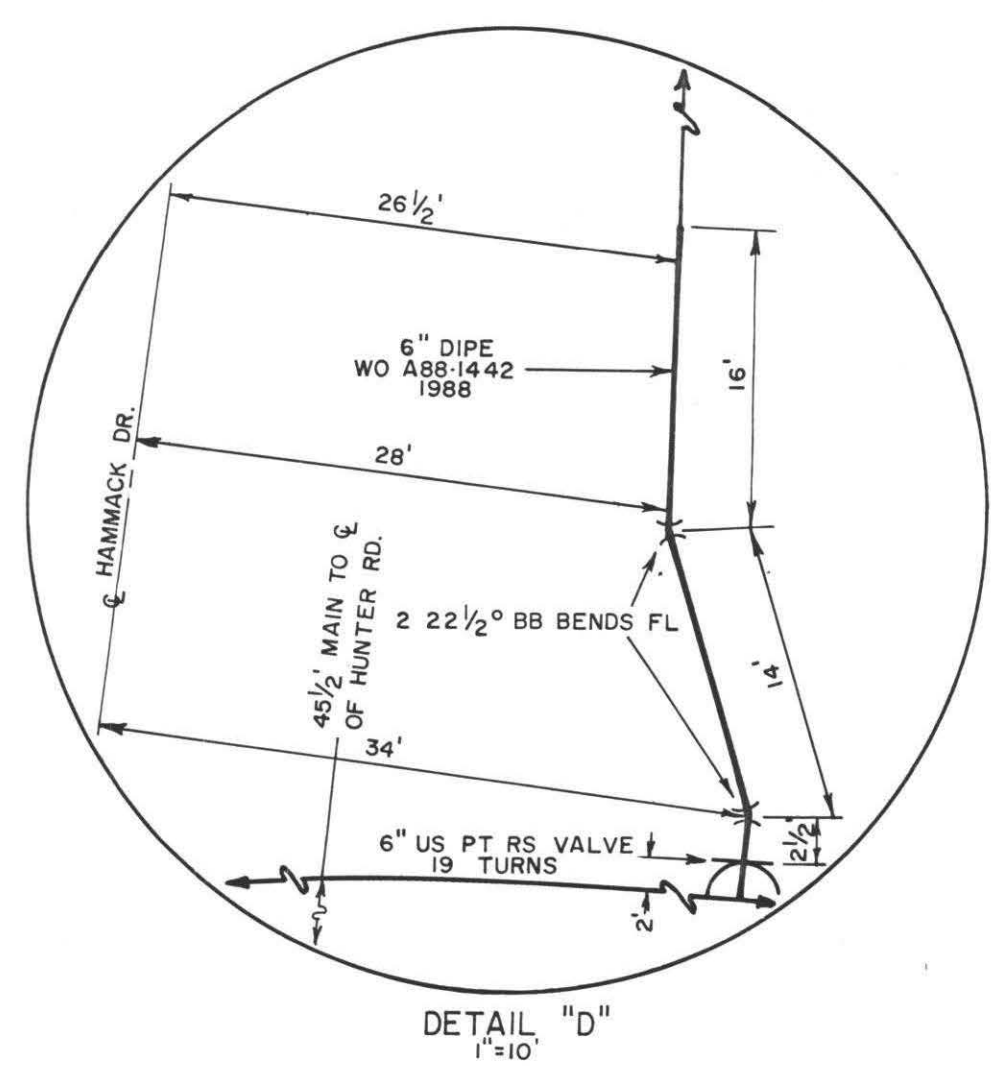
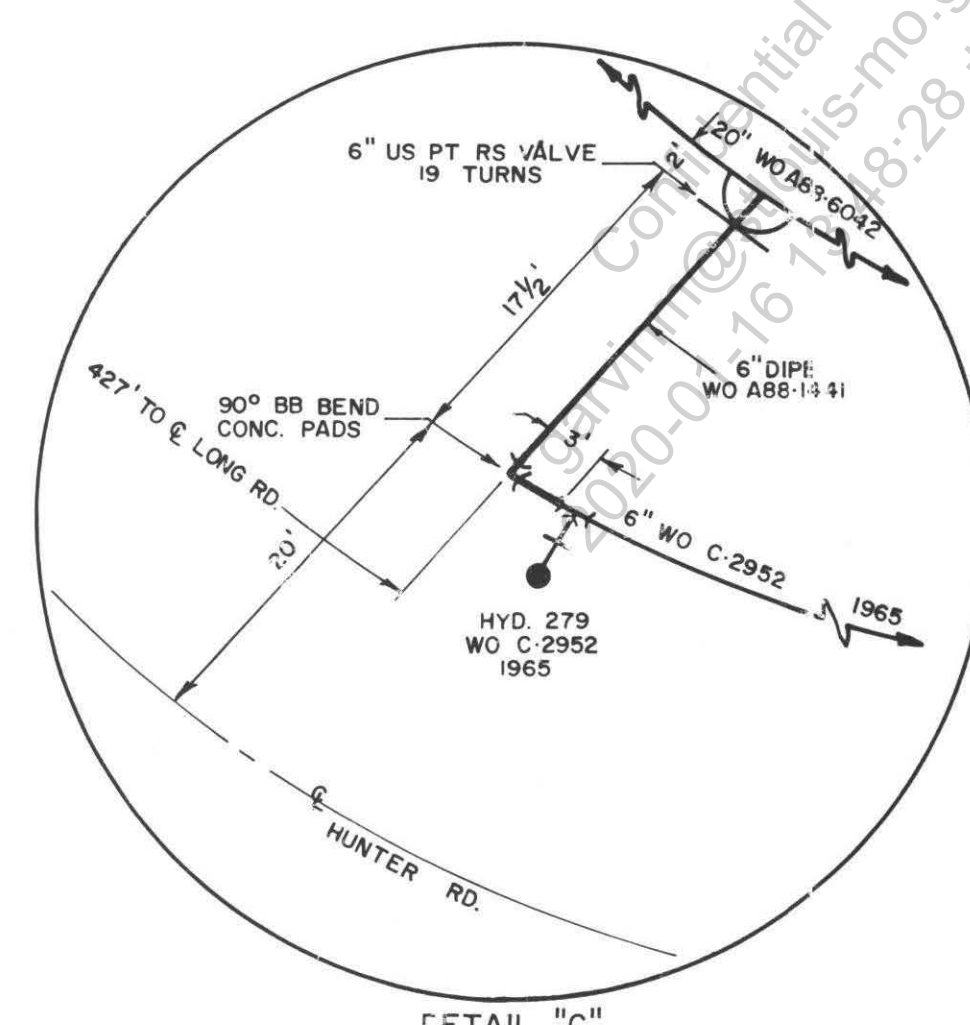
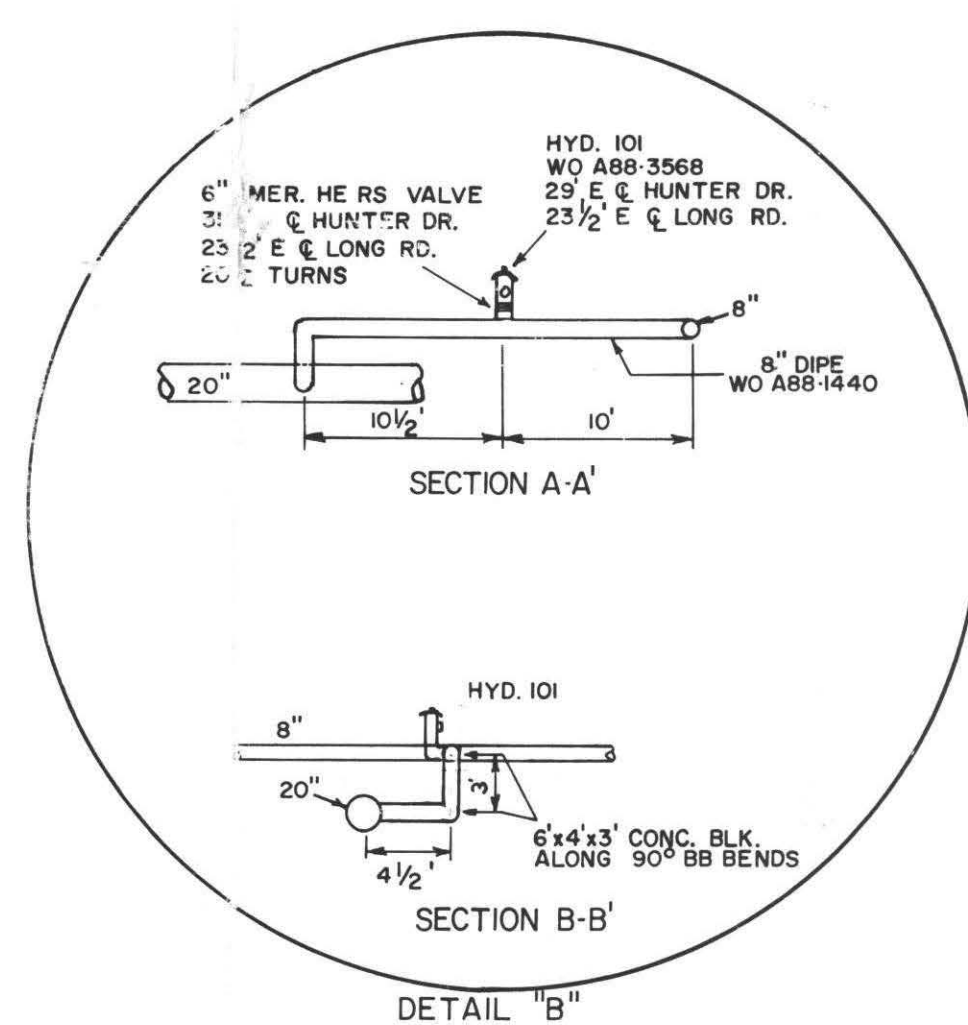
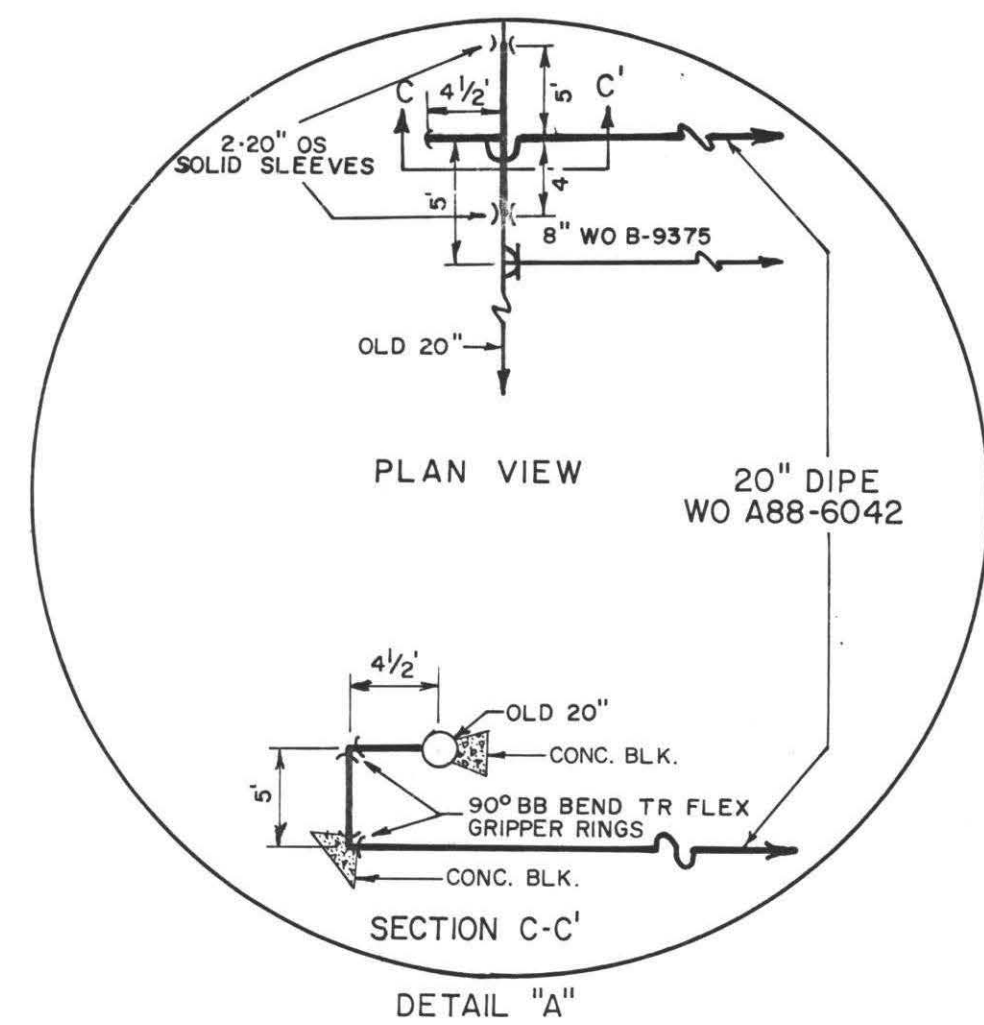


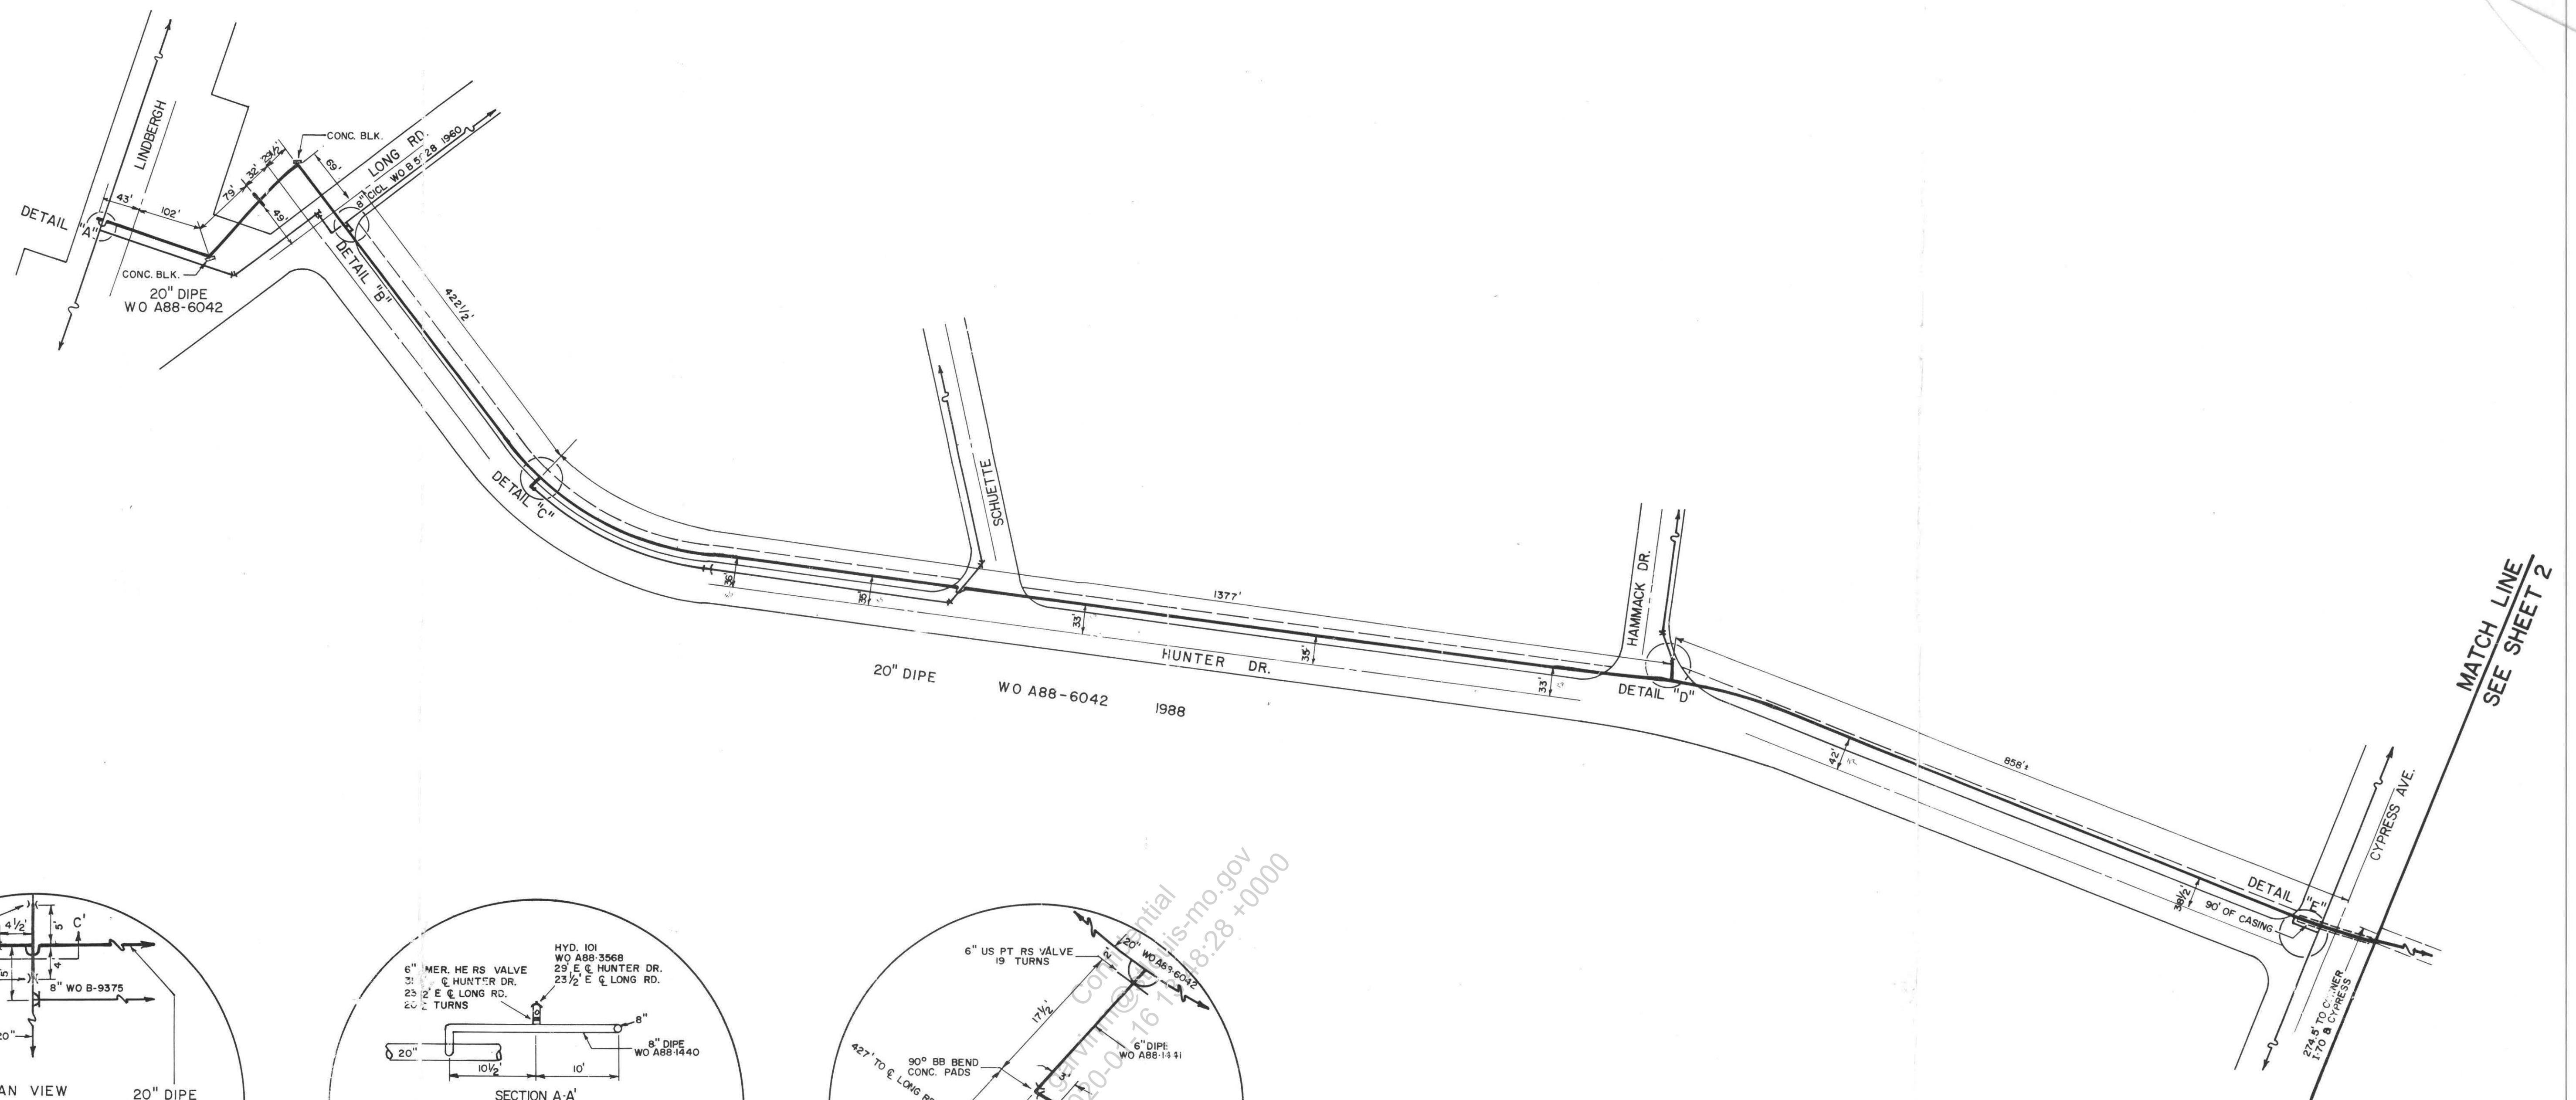

1 INCH BETWEEN MARKS
[-----]

FINAL PLANS SHOWING PROJECT AS BUILT

ST. LOUIS COUNTY WATER CO. ST. LOUIS, MO.	
20" MAIN LINDBERGH to AIRPORT TERMINAL	
SCALE - 1"=100' DATE - 12-88 BY S.R.G. # G.W.	FILE NO. 343-11-185/0 W.O. NO. AS NOTED DWG. NO. 1 of 3