
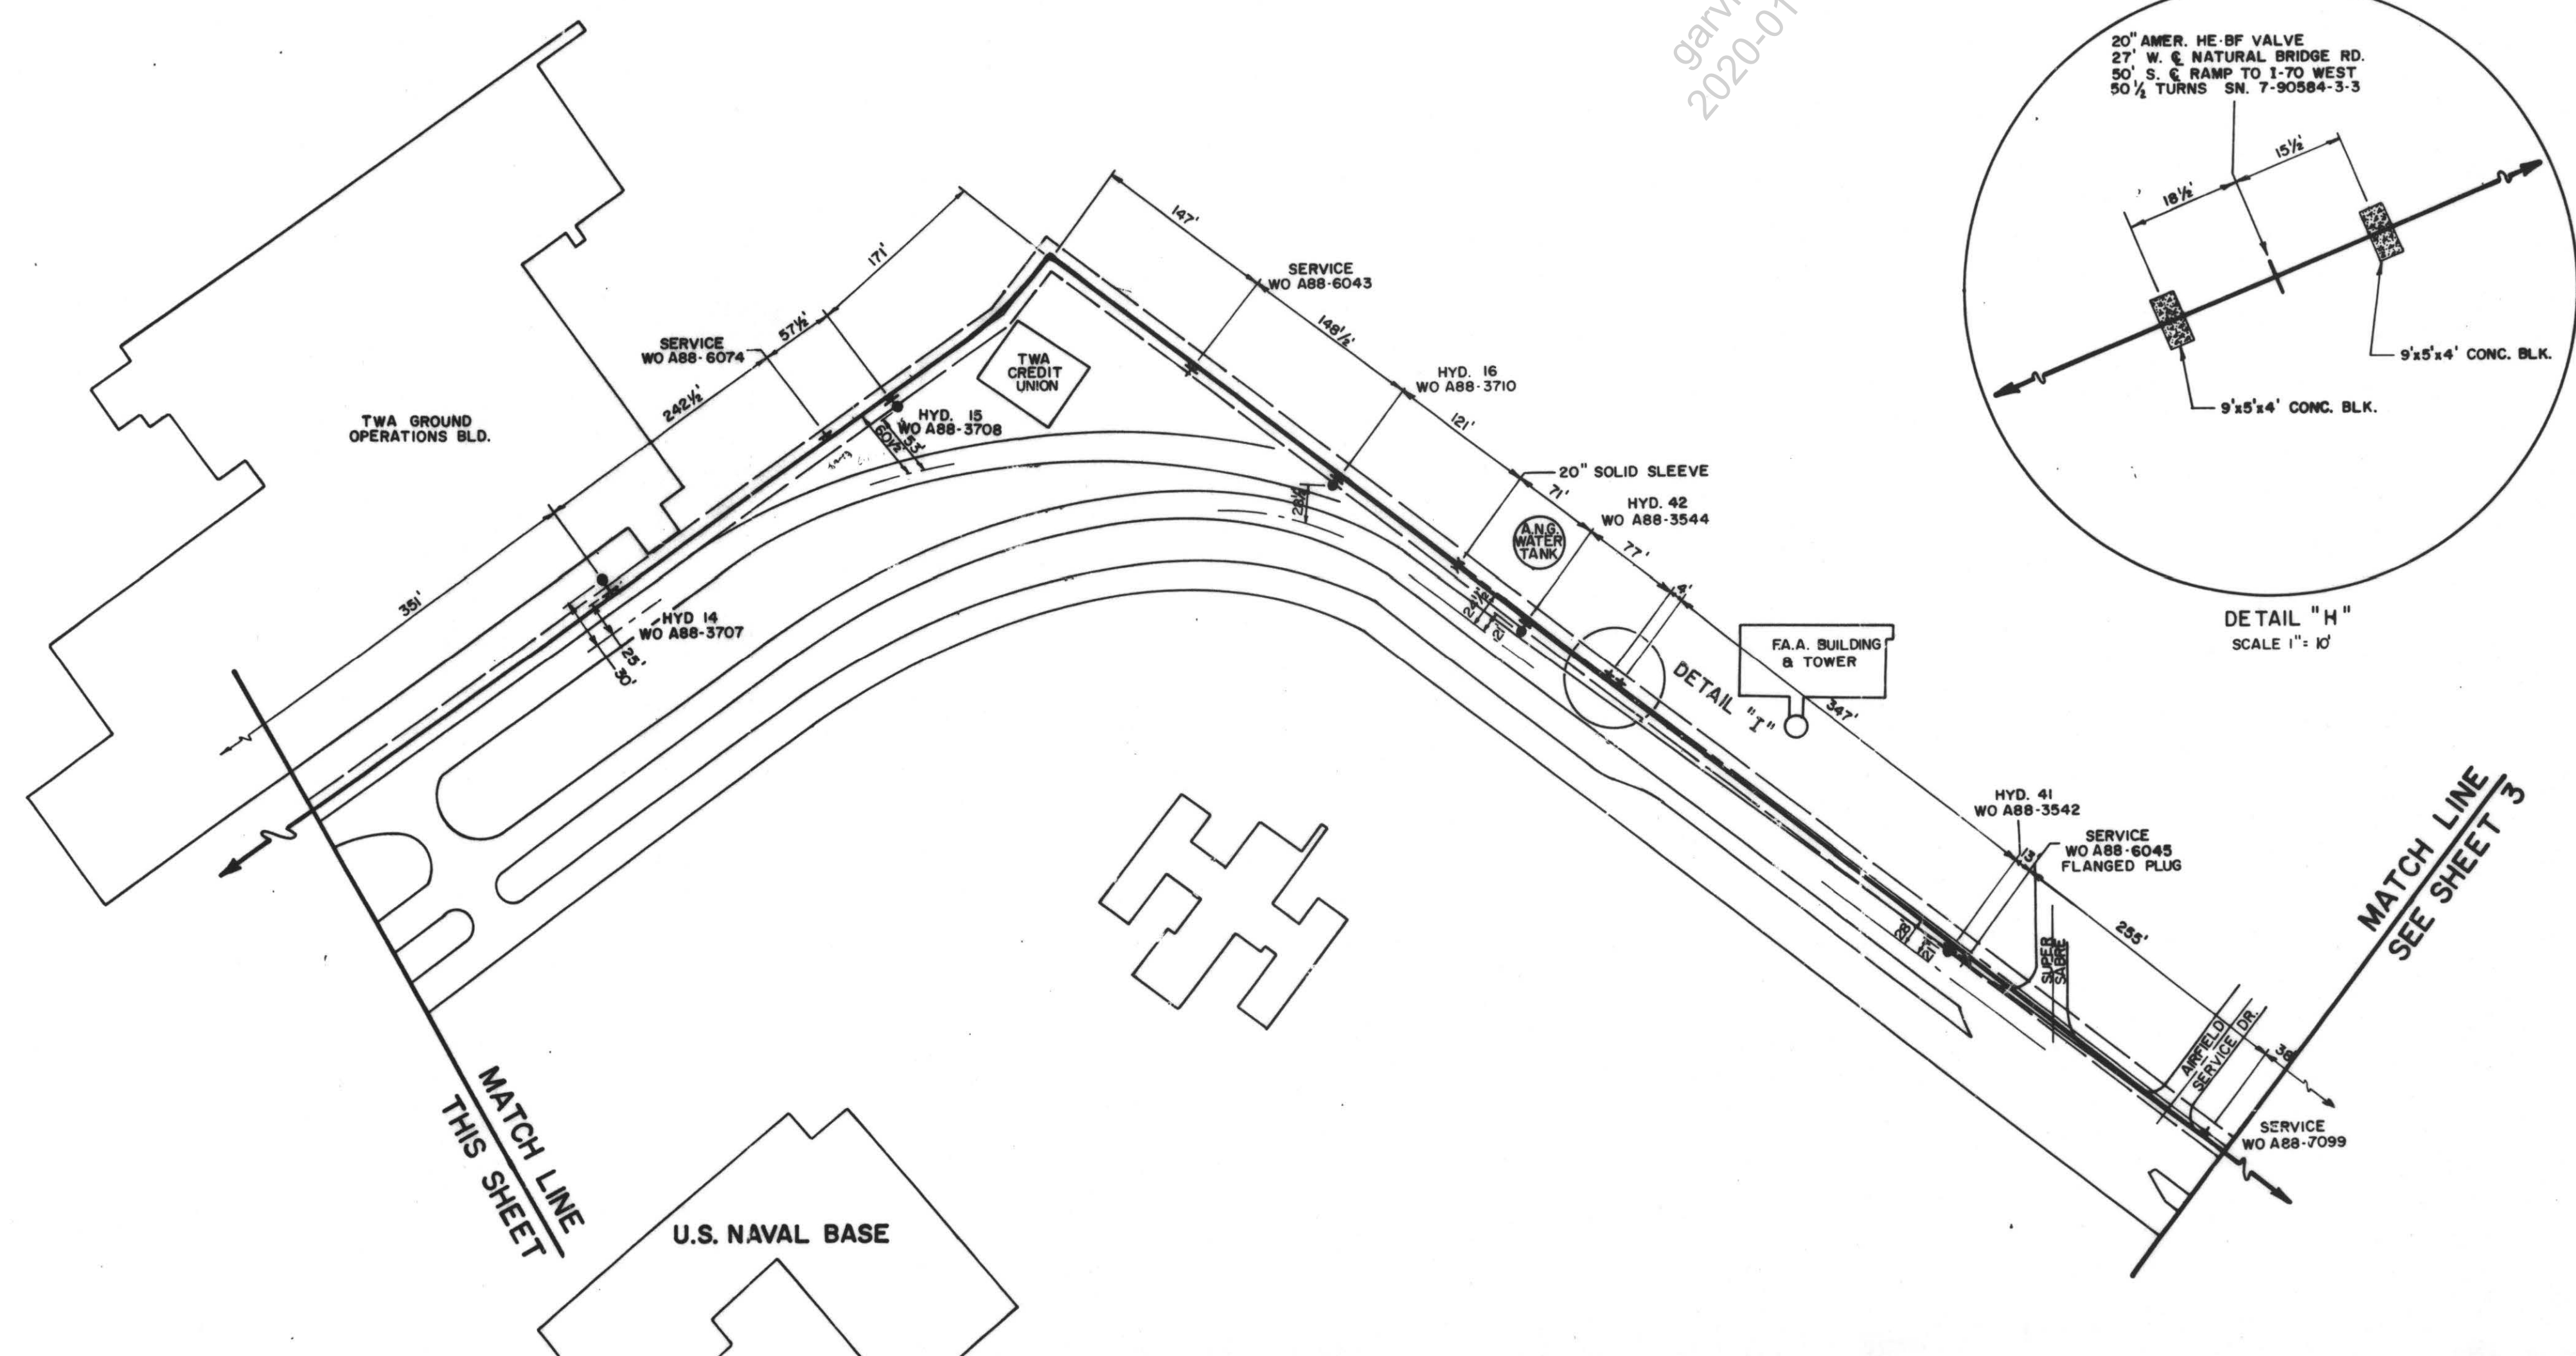
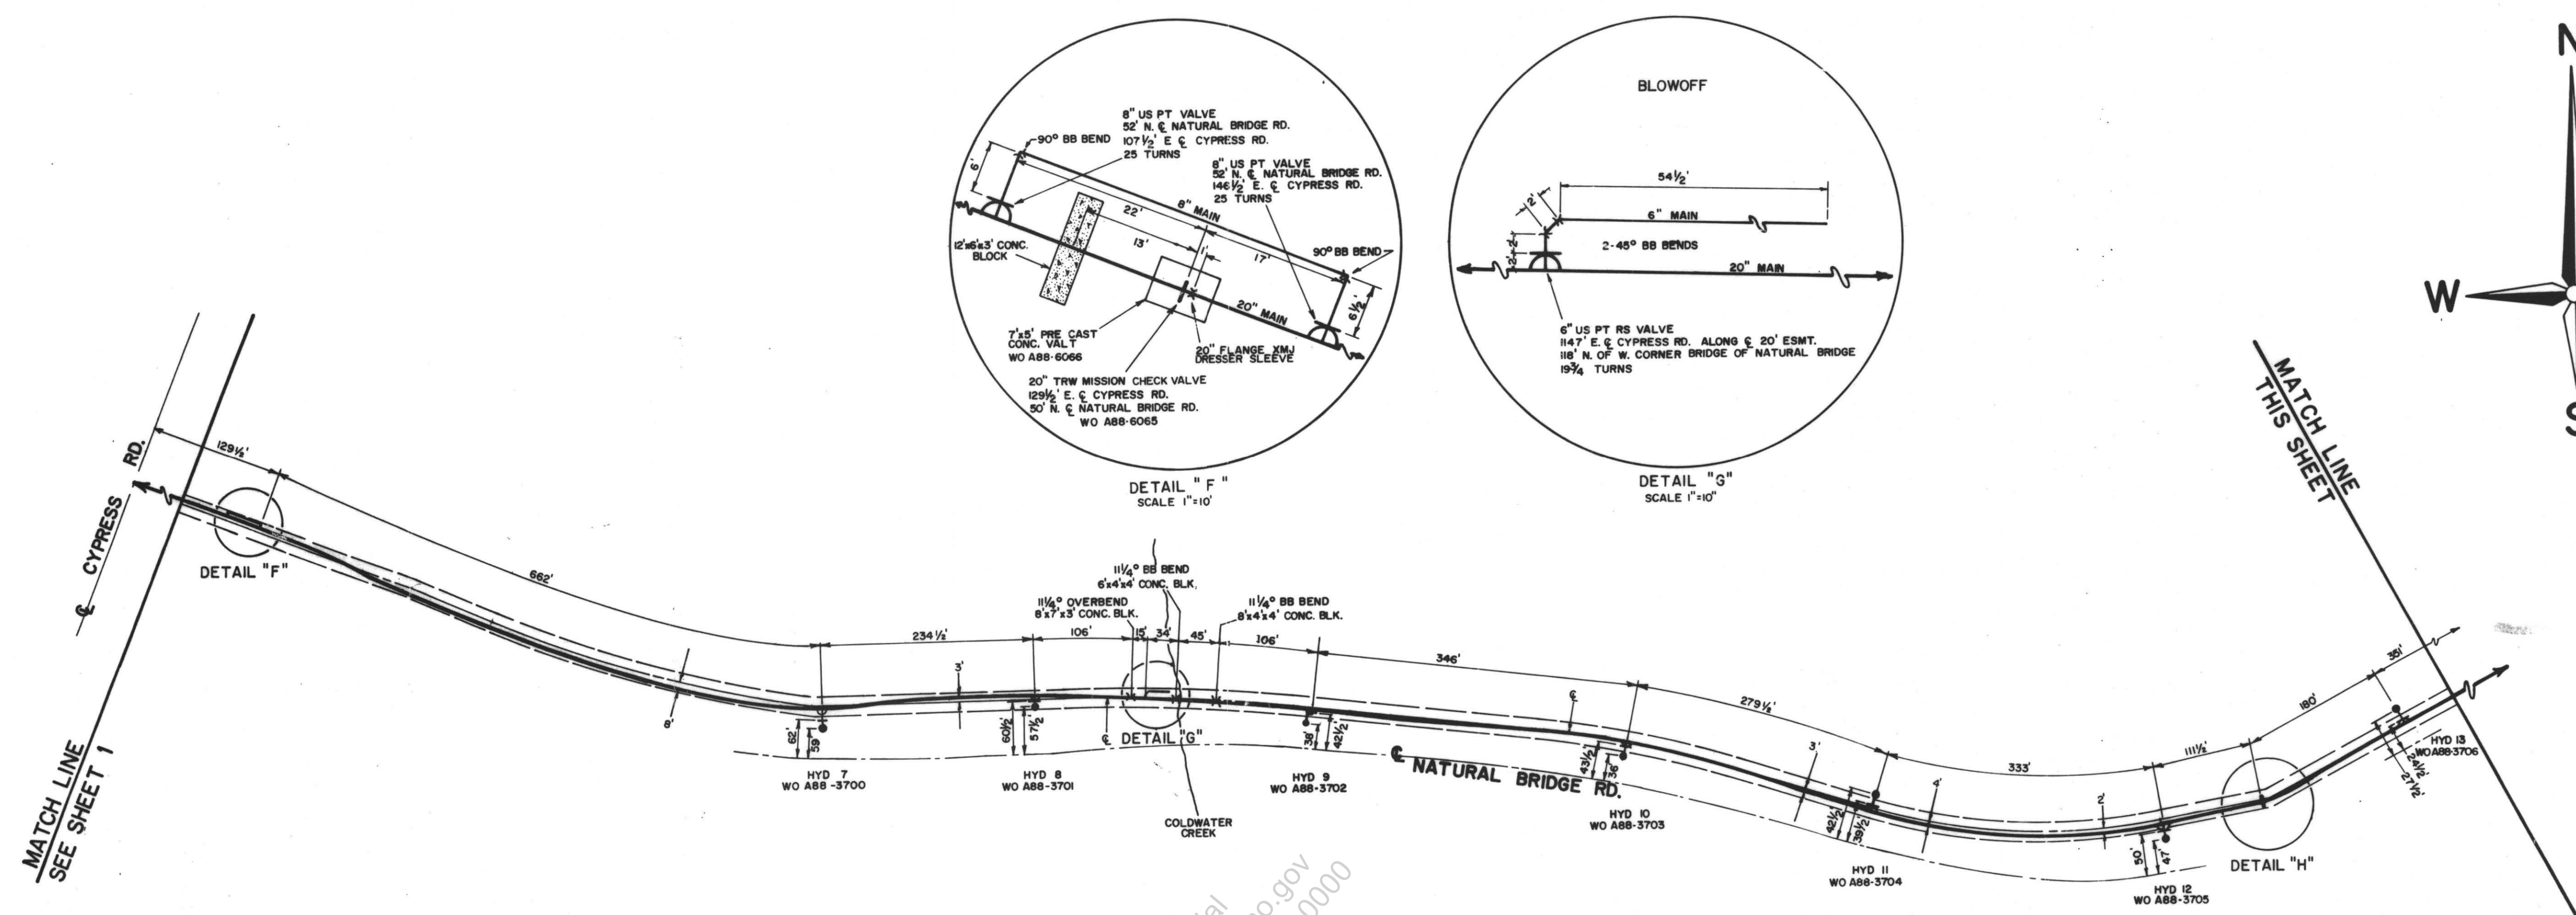


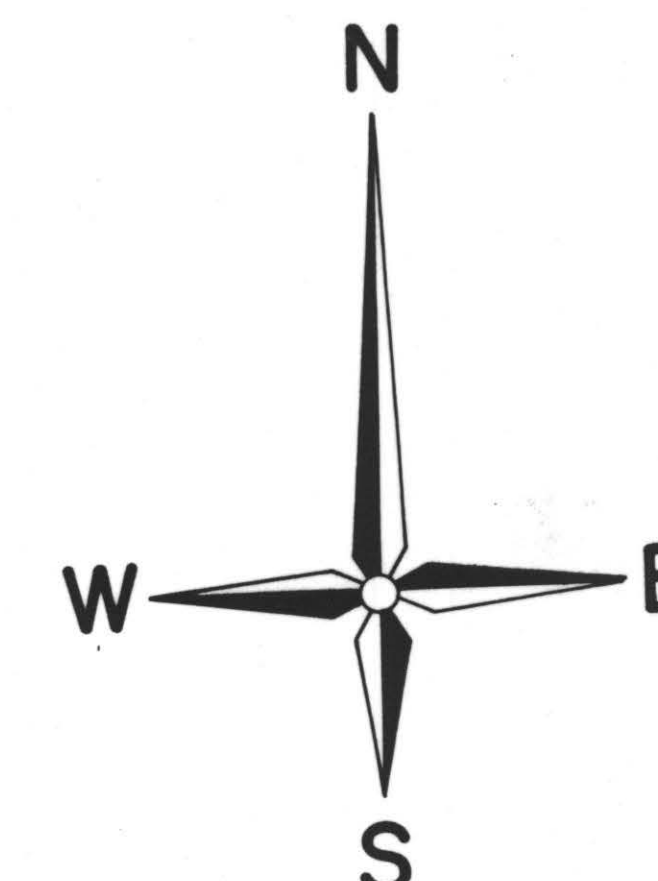

FINAL PLANS SHOWING PROJECT AS BUILT

ST. LOUIS COUNTY WATER CO. ST. LOUIS MO.	
20" MAIN LINDBERGH to AIRPORT TERMINAL	
SCALE: 1"=100'	FILE NO. 343-11-185/0
DATE: Sept. thru Dec. 1988	W.O. NO. AS NOTED
BY S.P.G.	DWG. NO. 2 OF 3

50001578.jpg